

USE FOR ALTERNATE "A" & "B"

REVISED 4-5-1966 AS CONSTRUCTED
THE INFORMATION SHOWN ON THIS DRAWING IS FOR
CONSTRUCTION PURPOSES ONLY.
VERIFY INFORMATION TAKEN FROM THIS DRAWING

GENERAL NOTE


THE LOCATION OF UTILITIES AND STRUCTURES, BOTH SURFACE AND SUB-SURFACE, ARE SHOWN ON THE PLANS FROM DATA AVAILABLE AT TIME OF SURVEY AND IS NOT NECESSARILY COMPLETE OR CORRECT. THE EXACT LOCATION AND PROTECTION OF UTILITIES AND STRUCTURES IS THE RESPONSIBILITY OF THE CONTRACTOR. DURING CONSTRUCTION THE CONTRACTOR SHALL USE DUE DILIGENCE IN PROTECTING FROM DAMAGE ALL EXISTING UTILITIES AND STRUCTURES WHETHER SHOWN ON THE PLANS OR NOT. IF DAMAGE IS CAUSED, THE CONTRACTOR SHALL BE RESPONSIBLE FOR REPAIR OR RESTORATION OF SAME IN ACCORDANCE WITH THE DIRECTIONS OF THE ENGINEERS AND FOR ANY RESULTING CONTINGENT DAMAGE.

"SUB-SURFACE CONDITIONS." IT IS THE OBLIGATION AND RESPONSIBILITY OF THE BIDDER TO MAKE HIS OWN INVESTIGATIONS OF SUB-SURFACE CONDITIONS PRIOR TO SUBMITTING HIS PROPOSAL. THE BIDDER MAY EXAMINE AT THE OFFICE OF THE LAKE COUNTY SANITARY ENGINEER THE RECORDS OF ALL BORINGS, TEST EXCAVATIONS AND OTHER SUB-SURFACE INVESTIGATIONS, IF ANY, MADE SOLELY FOR DESIGN PURPOSES FOR THE OWNER. SAID BORINGS, TEST EXCAVATIONS, AND OTHER SUB-SURFACE INVESTIGATIONS ARE INCOMPLETE, ARE NOT A PART OF THE CONTRACT DOCUMENTS, AND ARE NOT WARRANTED TO SHOW THE ACTUAL SUB-SURFACE CONDITIONS. THE CONTRACTOR AGREES THAT HE WILL MAKE NO CLAIM AGAINST THE OWNER OR THE ENGINEER, IF, IN CARRYING OUT THE WORK, HE FINDS THAT THE ACTUAL SUB-SURFACE CONDITIONS ENCOUNTERED DO NOT CONFORM TO THOSE INDICATED BY SAID BORINGS, TEST EXCAVATIONS AND OTHER SUB-SURFACE INVESTIGATIONS.

WHERE SEWER CONSTRUCTION IS ADJACENT TO WATER LINES OR HYDRANTS, CONTRACTOR TO PROVIDE NECESSARY SUPPORT, TIES AND/OR BLOCKING AS MAY BE APPROVED BY THE ENGINEER. COST OF THE ABOVE PROTECTION SHALL BE INCLUDED IN THE PRICE BID PER LINEAL FOOT OF SEWER.

MEASUREMENTS INDICATED IN THE PLANS TO POLES, TREES, BUILDINGS, MANHOLES, AND OTHERS ARE TO THE NEAREST FACE OF THE INDICATED STRUCTURE.

WHERE NO CONCRETE CURB OR CUTTER EXISTS, IT WILL BE CONSIDERED THAT ALL STREETS IN THIS CONTRACT HAVE AN EXISTING BERM ON BOTH SIDES. WHEN DAMAGED OR DESTROYED, ALL BERMS SHALL BE CONSIDERED TO HAVE A WIDTH OF 18" FOR REPLACEMENT PURPOSES.

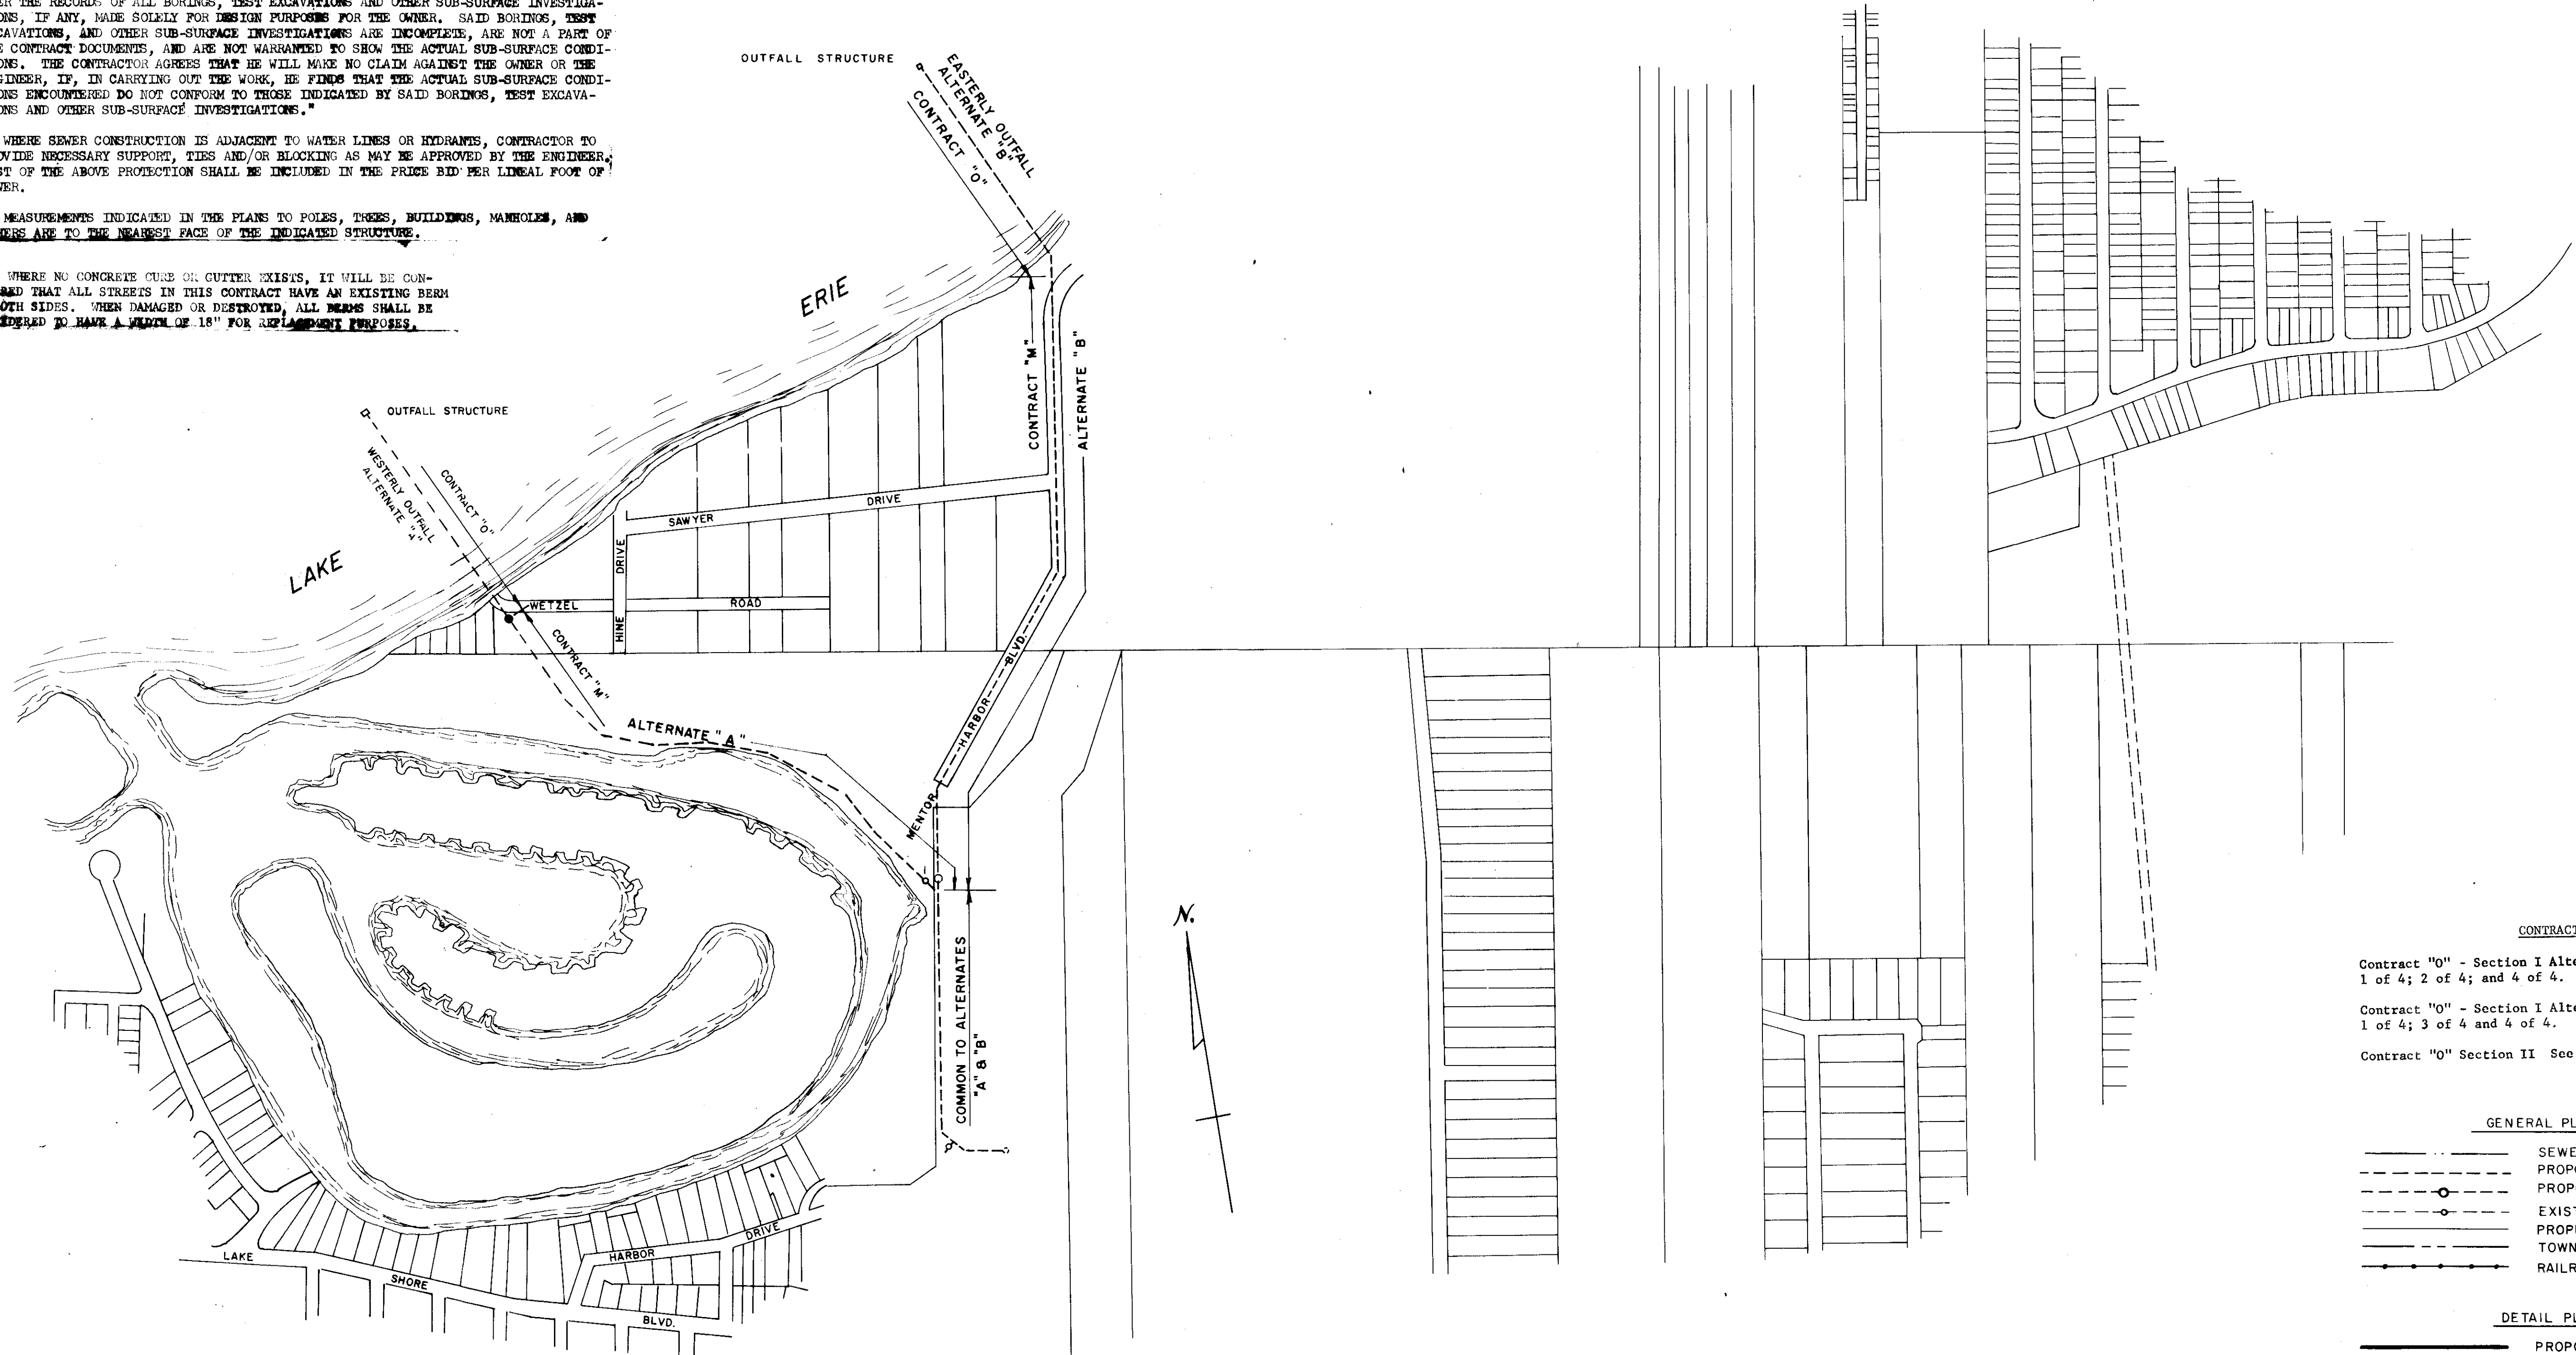

- CONTRACT "O"**
- Contract "O" - Section I Alternate "A". See Sheets 1 of 4; 2 of 4; and 4 of 4.
- Contract "O" - Section I Alternate "B". See Sheets 1 of 4; 3 of 4 and 4 of 4.
- Contract "O" Section II See Sheet 4 of 7.
- GENERAL PLAN LEGEND**
- SEWER DISTRICT BOUNDARY
 - PROPOSED SEWERS
 - PROPOSED MANHOLES
 - EXISTING MANHOLES
 - PROPERTY & RIGHT OF WAY LINES
 - TOWNSHIP LINES
 - RAILROADS
- DETAIL PLAN LEGEND**
- PROPOSED SANITARY SEWERS
 - EXISTING SANITARY SEWERS
 - STORM SEWER
 - STORM SEWER MANHOLE OR INLET
 - WATER LINES
 - GAS LINES
 - UNDERGROUND CABLE
 - POWER POLE

K-281